


Cathedral Pines Mountain Bike Trail

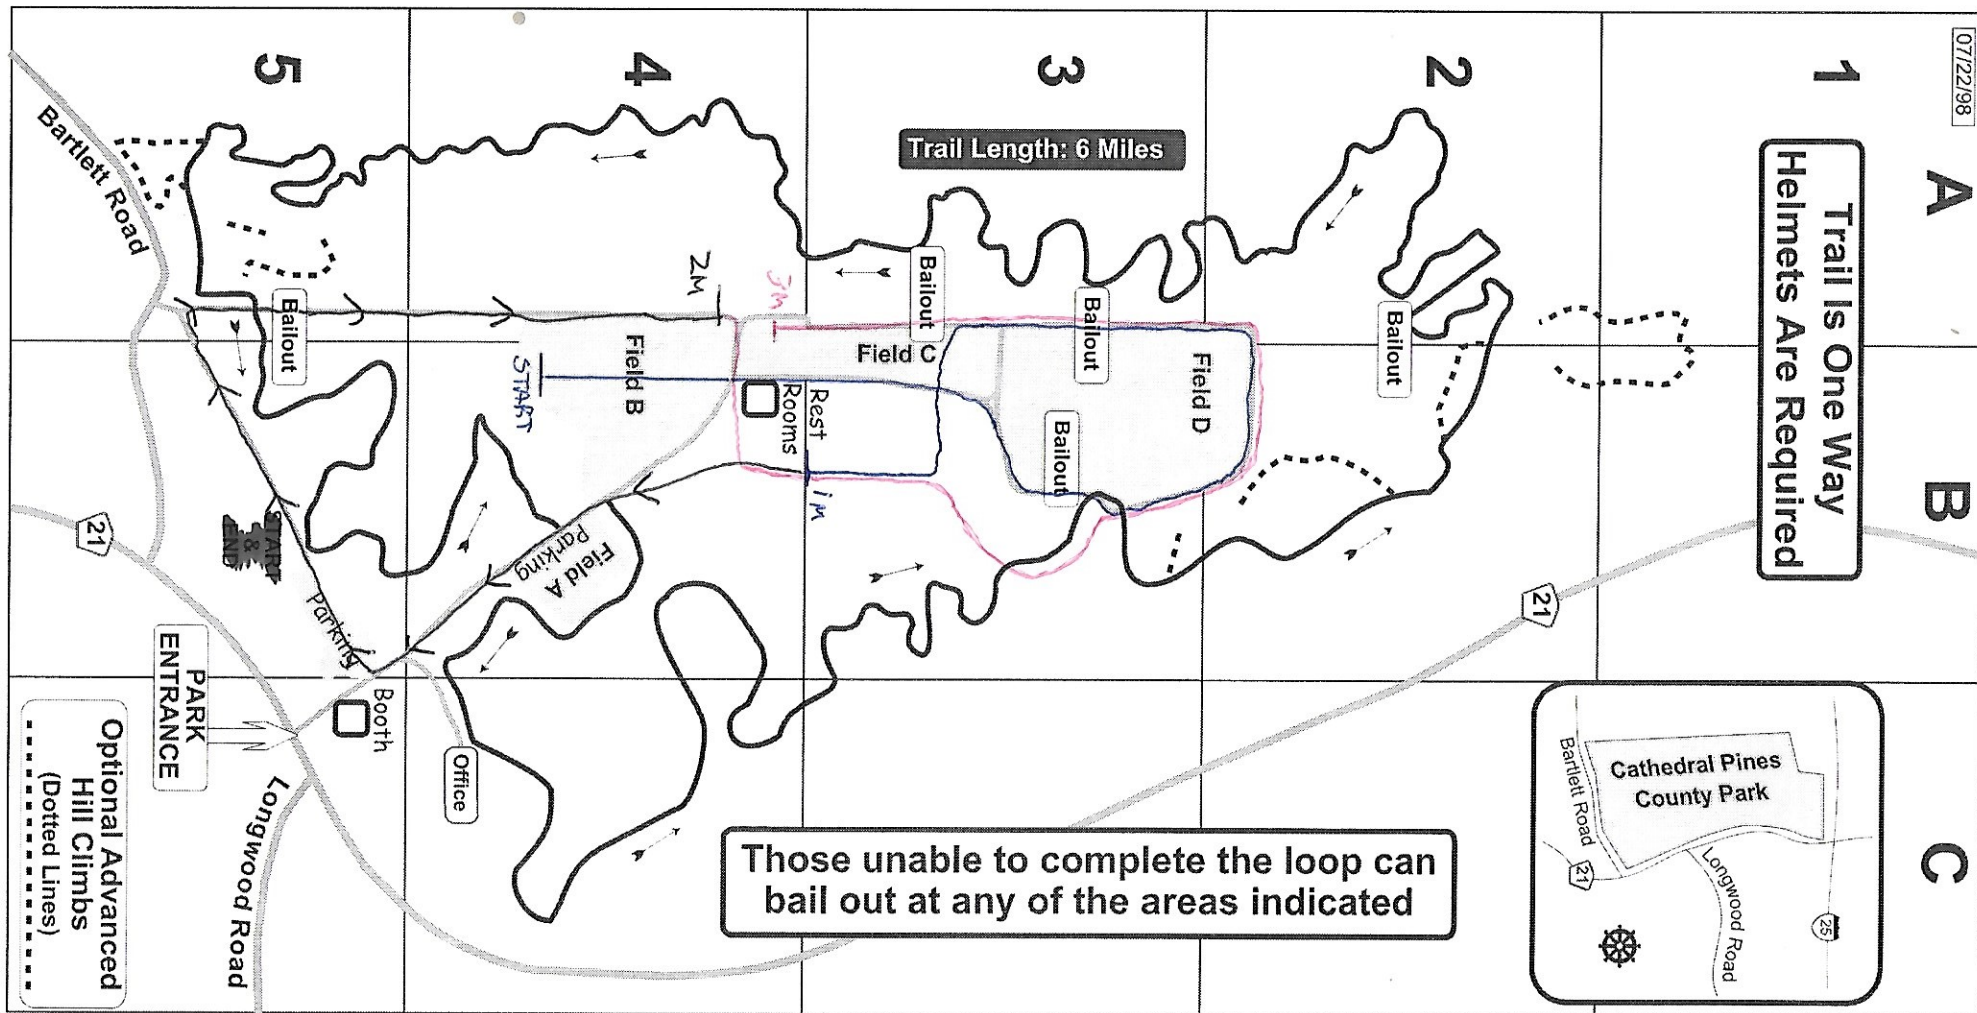


For safety and prevention of erosion, Trail Is One Way. A bicycle helmet is required for ALL riders. Eye protection is recommended for all riders. A Suffolk County Green Key is required. For information, see one of the park staff or call 244-7275.

This trail is maintained by volunteers. If you ride this trail regularly and would like to help, please call the CLIMB Hot Line. For information regarding this trail or to report any hazardous trail conditions, call the CLIMB Hot Line at 271-6527 or Suffolk Parks at 854-4949.

Please do your part to reduce litter on our trail and in the park. Pick up any litter you see and deposit it in the nearest receptacle.

This trail was built by and is maintained by the members of C.L.I.M.B.

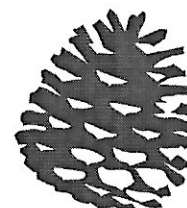

SUFFOLK
COUNTY
PARKS